



# RECORD OF SURVEY NO. 31-8

IN THE NW 1/4 OF THE NE 1/4 OF SEC. 29, T8N,  
R23E, MDB & M.

### RECORDER'S CERTIFICATE

Filed this 24 day of June,  
1980, at 1:10 P.M. in Book 7 of  
Record Survey at page 51 at the  
request of Antelope-Topaz, Inc.  
#634

*Ruby A. Strait*  
County Recorder

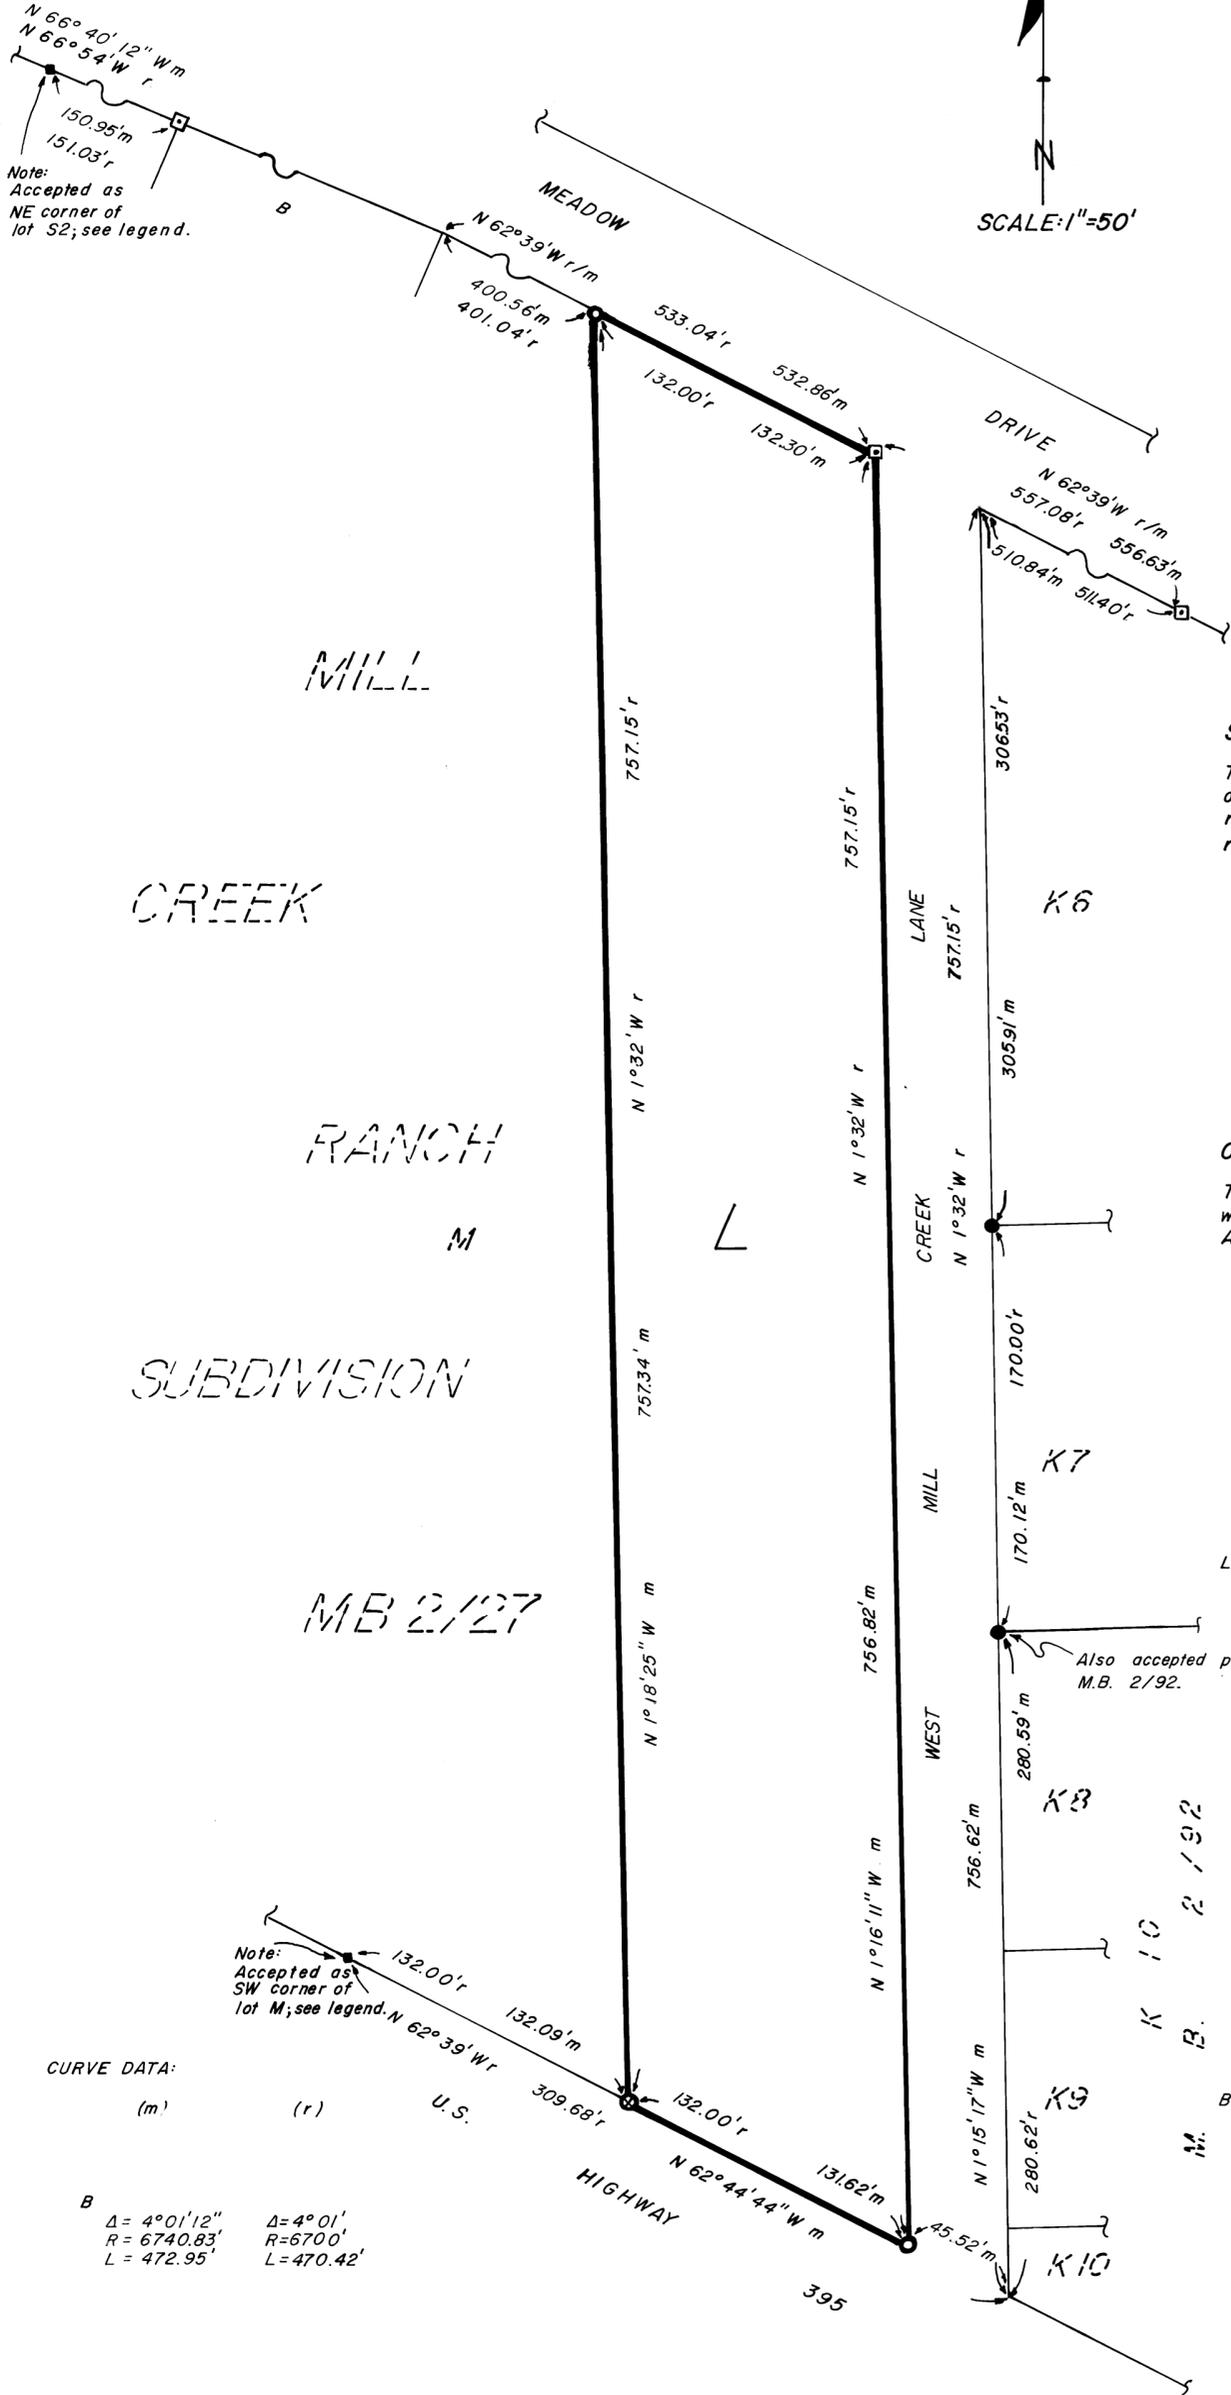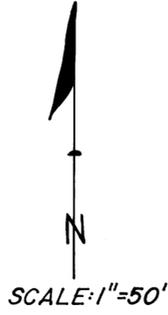

### SURVEYOR'S CERTIFICATE

This map correctly represents a survey made by me  
or under my direction in conformance with the  
requirements of the Land Surveyor's Act at the  
request of Antelope-Topaz, Inc. on February, 1980.

*John R. Langford*  
A.C.E. No. 27104  
STATE OF CALIFORNIA

### COUNTY SURVEYOR'S CERTIFICATE

This map has been examined for conformance  
with the requirements of the Land Surveyor's  
Act this 24 day of June, 1980.

*Richard J. Melvin*  
A.C.E. No. 78098  
COUNTY SURVEYOR  
STATE OF CALIFORNIA

### LEGEND:

- Found old, undisturbed 2"X2" H.&T. Bearing and distance substantially conform to record information as shown on MB 2/27.
  - Concrete monument 6"X6"X12" with brass cap stamped CE 7522.
  - ⊙ Found old, undisturbed 2"X2" H.&T. Accepted as SW corner of lot L. Replaced with 1" I.D. I.P. & tag R.C.E. 27104.
  - Set 1" I.D. I.P. & tag R.C.E. 27104.
  - Found 3/8" diameter rebar painted orange. Monuments of this type have been commonly set by Walter Reid R.C.E. 7522. Monuments substantially conform to record information as shown on MB 2/27. Accepted as lot K7 corners.
- r Based on record information.  
m Based on field measurements.  
r/m Based on record information & field measurements.

BASIS OF BEARING: N 62° 39' W the south R/W line of Meadow Drive as shown on MB 2/27.

### CURVE DATA:

(m)	(r)	U.S.
B	$\Delta = 4^{\circ} 01' 12''$	$\Delta = 4^{\circ} 01'$
	$R = 6740.83'$	$R = 6700'$
	$L = 472.95'$	$L = 470.42'$

R/S Book 7 Page 51