EASI FILE CORP. IRVINE, CA. EFM 24

RS BK1 PG 46
36-19

SCALE: 1" = 50'

ONE SHEET ONLY

RECORD OF SURVEY No. 36-19

IN THE COUNTY OF MONO, STATE OF CALIFORNIA, OF A PORTION OF SECTION 9 AND A PORTION OF SECTION 16, ALL WITHIN TOWNSHIP 3 SOUTH, RANGE 27 EAST, M.D.M.

Inst. No. 3640.
Filed this 7 day of November, 1979, at 1:00 P.M. in Book 1 of Record Survey at Page 46 at the request of the United States Forest Service.

Ruby L. Strait
County Recorder

This map correctly represents a survey made by me or under my direction in conformance with the requirements of the Land Surveyor's Act on September 11, 1979, at the request of the United States Forest Service.

Gordon C. Holmes
Gordon C. Holmes RCE 10467

This map has been examined for conformance with the requirements of the Land Surveyor's Act this 5th day of November, 1979.

Richard L. Boyd, P.E.
County Surveyor

• Indicates a found monument as noted.

∘ Indicates a 2" I.P. and tag RCE 10467 set.

The bearings shown hereon are based on solar observation and are true.

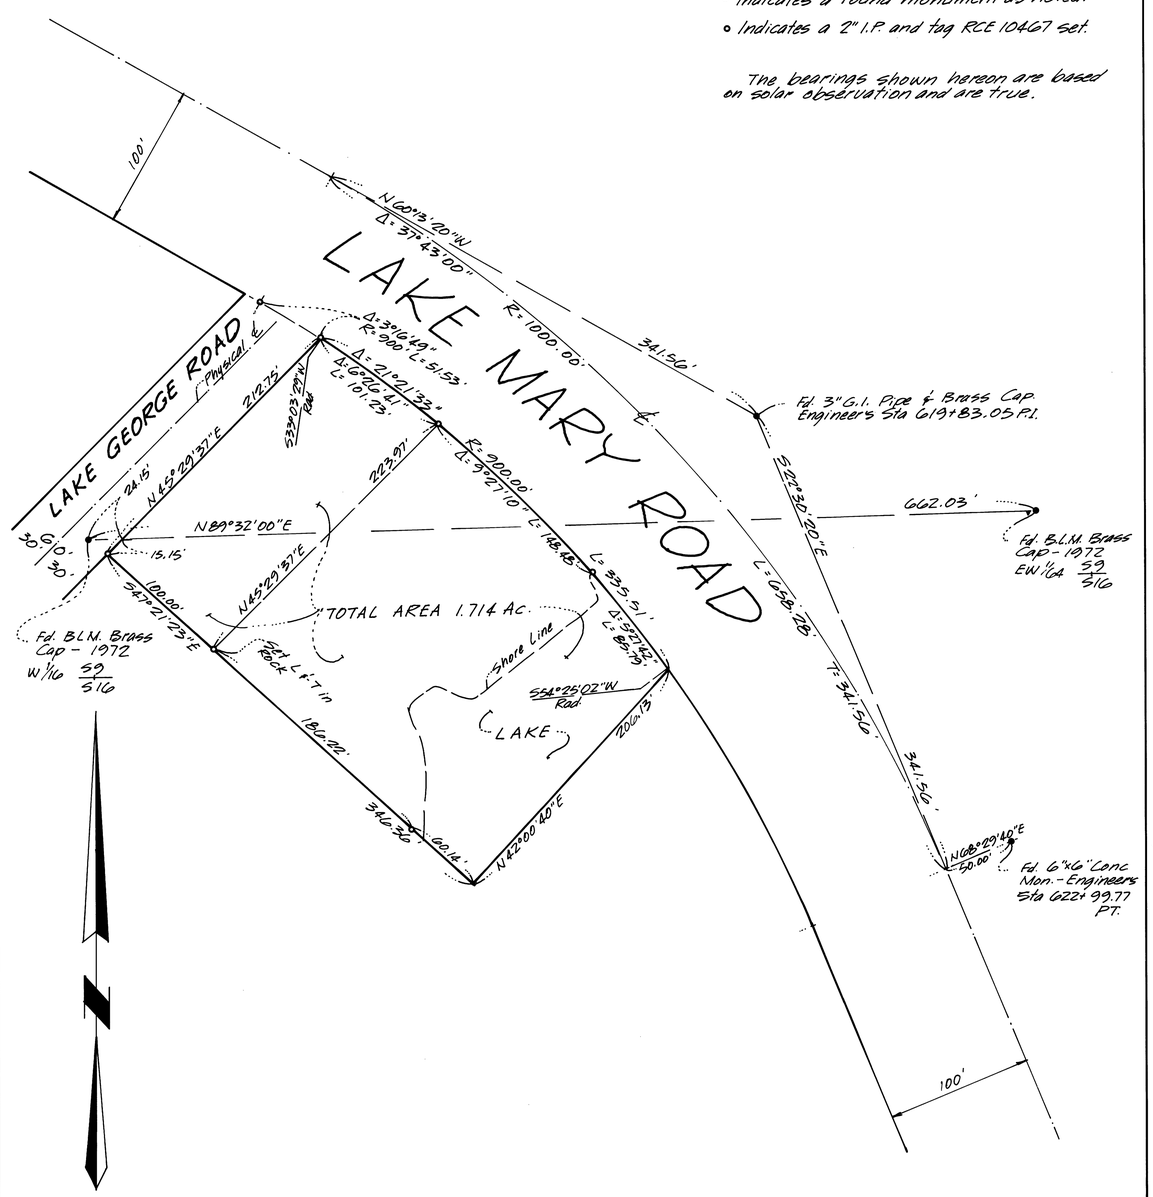

RS Vol. 1 Page 46