RECORD OF SURVEY
NO. 36-27

IN THE COUNTY OF MONO, STATE OF CALIFORNIA, BEING A SURVEY OF A PORTION OF THE SOUTH 1/2 OF THE NORTHEAST 1/4 OF SECTION 3, AND A PORTION OF THE WEST 1/2 OF THE NORTHWEST 1/4 OF SECTION 2, TOWNSHIP 4 SOUTH, RANGE 27 EAST, MOUNT DIABLO MERIDIAN.

Surveyors Certificate
This map correctly represents a survey made by me or under my direction in conformance with the requirements of the Land Surveyors Act at the request of Dempsey Construction Corp., October, 1981.

David A. Laverty L.S. 4587

County Surveyors Certificate
This map has been examined for conformance with the requirements of the Land Surveyors Act this 2ND day of FEB, 1982.

Richard Boardman
Deputy Mono County Surveyor

RICHARD BOARDMAN L.S. 5

Recorders Certificate # 6547
Filed this 23rd day of February, 1982, at 2:00 p.m. in Book 1 of Land Surveys at page 79 73 at the request of Dempsey Construction Corp.

Mono County Recorder

Basis of Bearings
The basis bearings for this map is the southerly line of the Northeast quarter of Section 3, T 4 S, R 27 E, per M.B. 9/3.

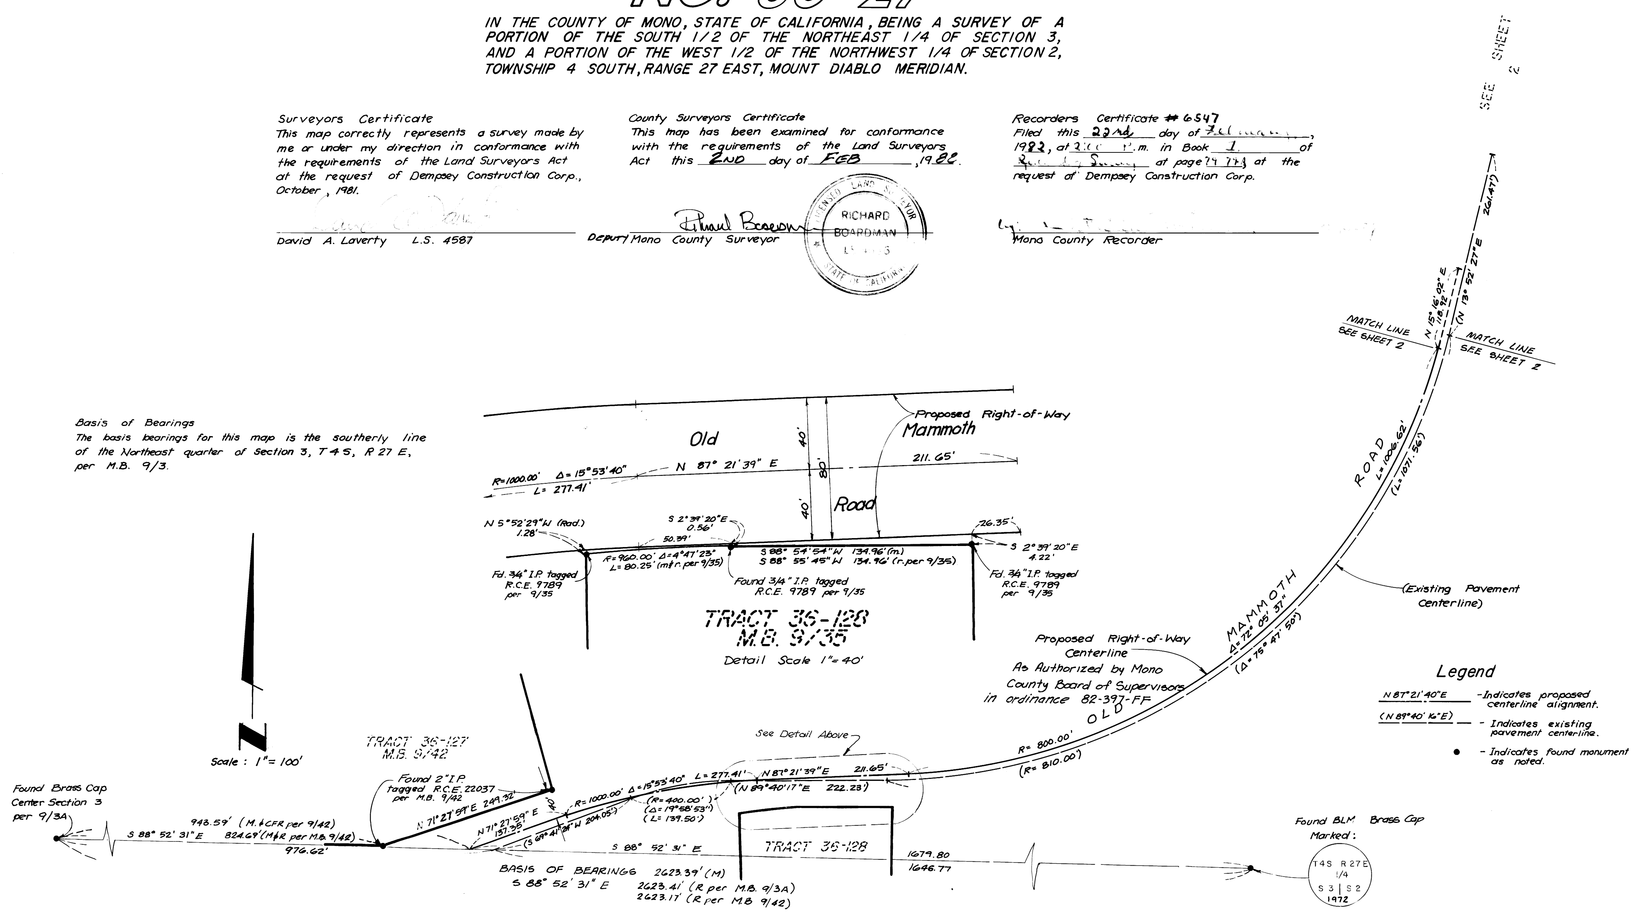

Legend

N 87°21'40"E	- Indicates proposed centerline alignment.
(N 89°40'16"E)	- Indicates existing pavement centerline.
●	- Indicates found monument as noted.

EFN24 EASY FILE CORP. IRVINE, CA.
As Built/ Bk. 77-71A
36-27