EASI FILE CORP. IRVINE, CA EFH 24

RS BK 2 PG. 36
36-52

Scale 1" = 30'

RECORD OF SURVEY 36-52

IN THE TOWN OF MAMMOTH LAKES, COUNTY OF MONO, STATE OF CALIFORNIA BEING A SURVEY FOR A LOT LINE ADJUSTMENT BETWEEN LOT 3 AND LOT 4 OF TRACT NO. 36-155 RECORDED IN BOOK 10 PAGES 2-2D OF MAPS IN THE OFFICE OF THE COUNTY RECORDER

The basis of bearings for this survey is the centerline of Ranch Rd. per MB 10/2-2D (N22°20'51"E)

- ● indicates found a 2" I.P. w/tag "LS 4587" per MB 10/2 unless otherwise noted
- △ indicates found a centerline monument w/tag "LS 4587" per MB 10/2
- ○ indicates set a 2" I.P. w/tag RCE 10467
- m. measured
- r. record per MB 10/2-2D
- ( ) record information

SURVEYOR'S STATEMENT

This map correctly represents a survey made by me or under my direction in conformance with the land surveyors' act at the request of John Hooper in November 1987

Gordon C. Holmes 2/4/88
Gordon C. Holmes
RCE 10467
Exp. 12-31-88

RECORDER'S CERTIFICATE

Document No. 6686
filed this 17th day of May 1988 at 1:55 PM. in Book 2 of ~~Record Surveys~~ at Page 36 at the request of John Hooper $5.00 fee

Renn Nolan
Mono Co. Recorder

By [illegible]
Deputy Co. Recorder

County Surveyors Statement

This map has been examined in accordance with section 8766 of the land surveyors' act this 17 day of May 1988

[illegible]
County Surveyor
RCE 22549

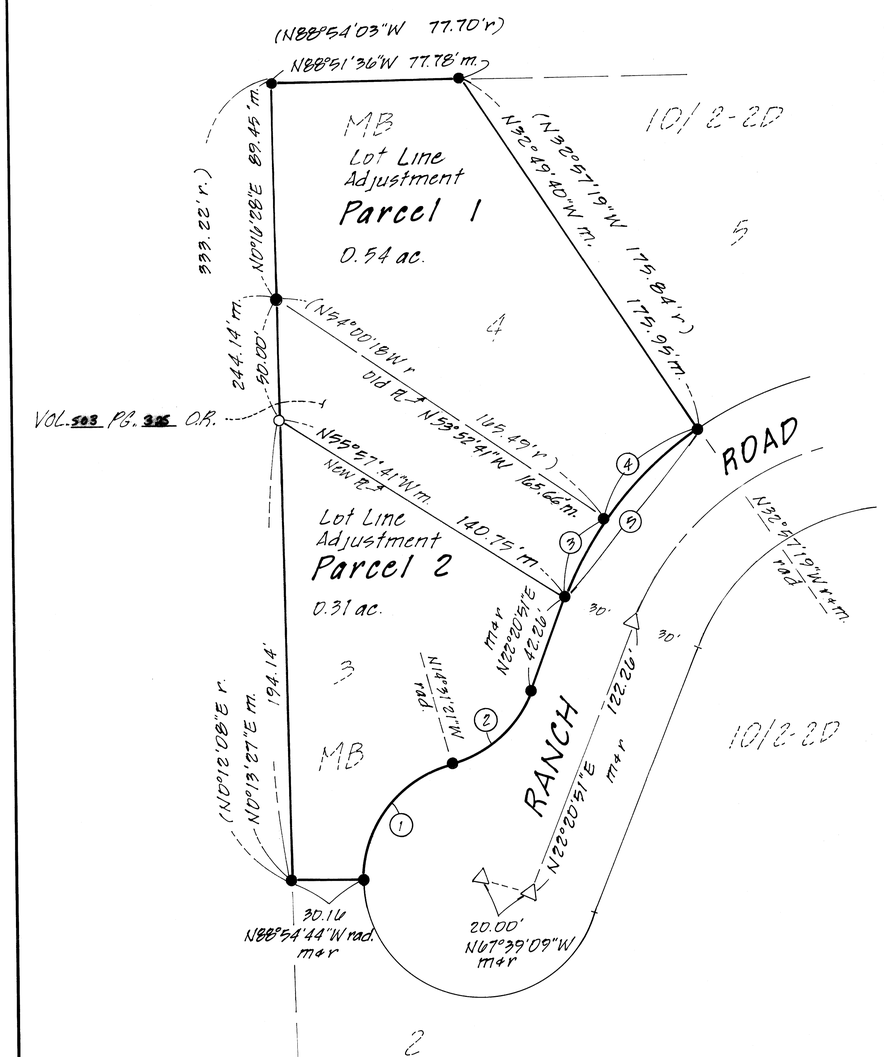

CURVE DATA

1. Δ = 74°23'23" m+r, R = 50', L = 64.92'
2. Δ = 53°07'47" m+r, R = 50', L = 46.36
3. Δ = 13°38'51" m+r, R = 150', L = 35.73
4. Δ = 21°02'59" m+r, R = 150', L = 55.11'
5. Δ = 34°41'50" m+r, R = 150', L = 90.84'

Vol. 2 Record of Survey Page 36