SCALE: 1"= 20'

1 SHEET ONLY

RECORD OF SURVEY NO. 37 – 81

IN THE UNINCORPORATED TERRITORY OF THE COUNTY MONO, STATE OF CALIFORNIA. BEING A SURVEY OF PARCELS LOCATED IN THE SOUTHWEST QUARTER OF THE SOUTHWEST QUARTER OF SECTION 26, TOWNSHIP 4 SOUTH, RANGE 29 EAST, M.D.B.& M. SAID PARCELS BEING FURTHER DESCRIBED AS LOT LINE ADJUSTMENT PARCEL 1 AND LOT LINE ADJUSTMENT PARCEL 2 AS SHOWN ON CERTIFICATE OF COMPLIANCE 06-03, RECORDED AS DOCUMENT No. 2006004135, IN THE OFFICIAL RECORDS OFFICE OF SAID COUNTY.

SURVEYOR'S STATEMENT:

THIS MAP CORRECTLY REPRESENTS A SURVEY MADE BY ME OR UNDER MY DIRECTION IN CONFORMANCE WITH THE REQUIREMENTS OF THE PROFESSIONAL LAND SURVEYOR'S ACT AT THE REQUEST OF MIKE HEVRON IN NOVEMBER 2006.

Andrew K. Holmes 12/02/08
ANDREW K. HOLMES DATE
L.S. 4428 LIC. EXP. 9-30-09

LICENSED LAND SURVEYOR ANDREW K. HOLMES EXP.9-30-2009 No.4428 STATE OF CALIFORNIA

COUNTY SURVEYOR'S STATEMENT:

THIS MAP HAS BEEN EXAMINED IN ACCORDANCE WITH SECTION 8766 OF THE PROFESSIOAL LAND SURVEYOR'S ACT THIS 5th DAY OF December 2008.

COUNTY SURVEYOR

John S. Parrish 12/05/2008
JOHN S. PARRISH DATE
L.S. 5050 LIC. EXP. 6-30-10

PROFESSIONAL LAND SURVEYOR JOHN S. PARRISH No. 5050 Exp. 06-30-10 STATE OF CALIFORNIA

RECORDER'S STATEMENT:

FILED THIS 10th DAY OF DECEMBER 2008, AT 10:45 A.M. IN BOOK 4 OF RECORD OF SURVEY MAPS AT PAGE 57 AT THE REQUEST OF MIKE HEVRON

LYNDA ROBERTS
MONO COUNTY RECORDER

BY: Sherrie R. Hale
DEPUTY COUNTY RECORDER

INSTRUMENT NO. : 2008005694
FEE : $8.00

PURPOSE OF SURVEY

THE REASON FOR THIS RECORD OF SURVEY IS AS SET FORTH IN THE PROFESSIONAL LAND SURVEYOR'S ACT, ARTICLE 5, 8762(b5): THE POINTS OR LINES SET DURING THE PERFORMANCE OF A FIELD SURVEY OF ANY PARCEL DESCRIBED IN ANY DEED OR OTHER INSTRUMENT OF TITLE RECORDED IN THE COUNTY RECORDER'S OFFICE ARE NOT SHOWN ON ANY SUBDIVISION MAP, OFFICIAL MAP, OR RECORD OF SURVEY.

BASIS OF BEARINGS

THE BASIS OF BEARINGS OF THIS MAP IS THE MEASURED LINE BETWEEN FOUND MONUMENTS AS SHOWN ON PMB 2/26, SAID BEARING BEING S 39°13'30" E AS SHOWN HEREON.

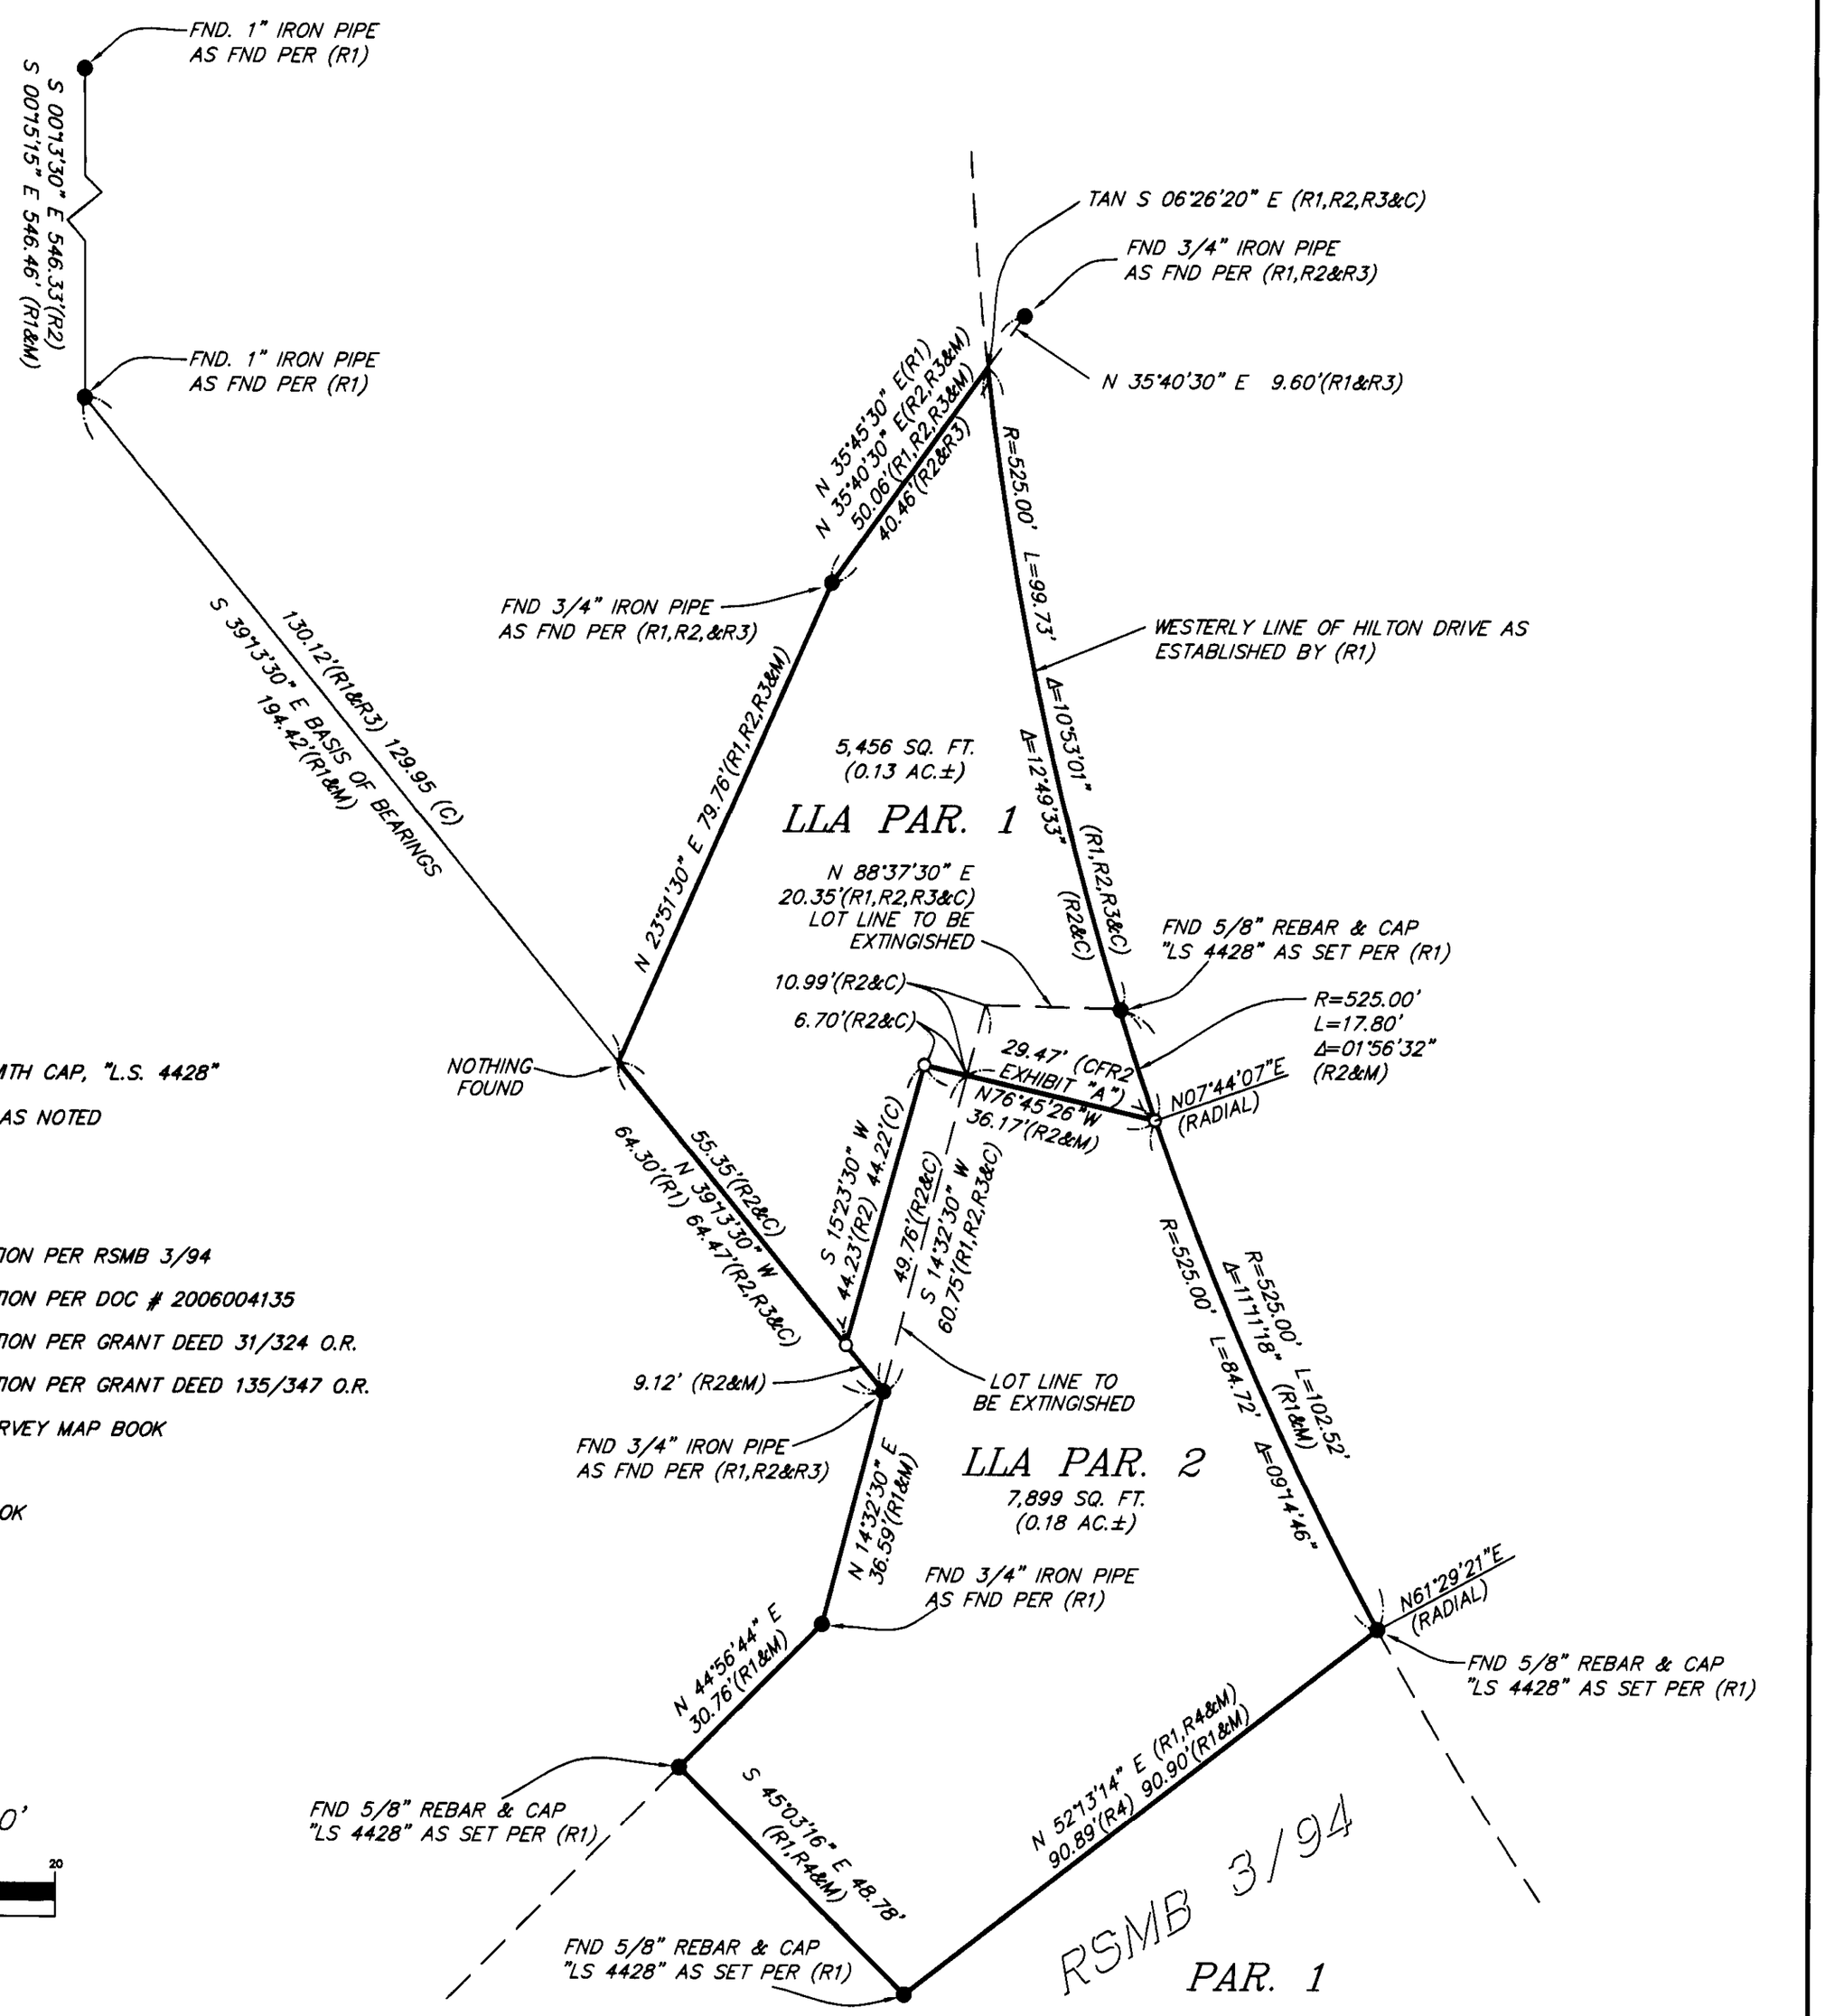

LEGEND

- ○ SET 5/8" REBAR WITH CAP, "L.S. 4428"
- ● FOUND MONUMENT AS NOTED
- C CALCULATED
- M MEASURED
- R1 RECORD INFORMATION PER RSMB 3/94
- R2 RECORD INFORMATION PER DOC # 2006004135
- R3 RECORD INFORMATION PER GRANT DEED 31/324 O.R.
- R4 RECORD INFORMATION PER GRANT DEED 135/347 O.R.
- RSMB RECORD OF SURVEY MAP BOOK
- FND FOUND
- PMB PARCEL MAP BOOK

SCALE: 1"=20'

20 0 10 20

triad/holmes associates

K:\01 Mammoth\1954-1\dwg\1954-1-llaRS-MYLAR.dwg Dec 02,2008 - 4:28pm, aro)